




LOT 112 & 113 - DIMENSIONS CORRECTED AS FOLLOWS:

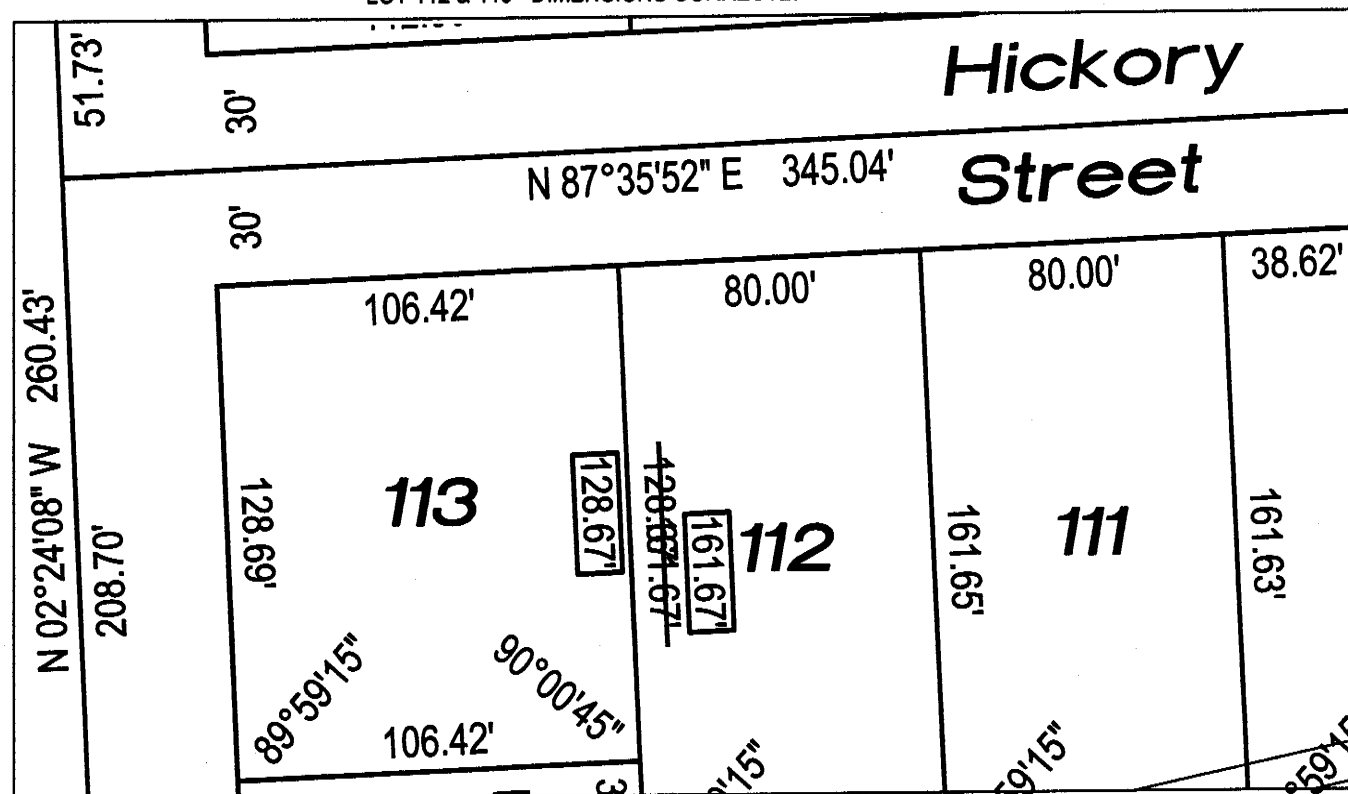


LOT 19 & 20 - ANGLES CORRECTED AS FOLLOWS:

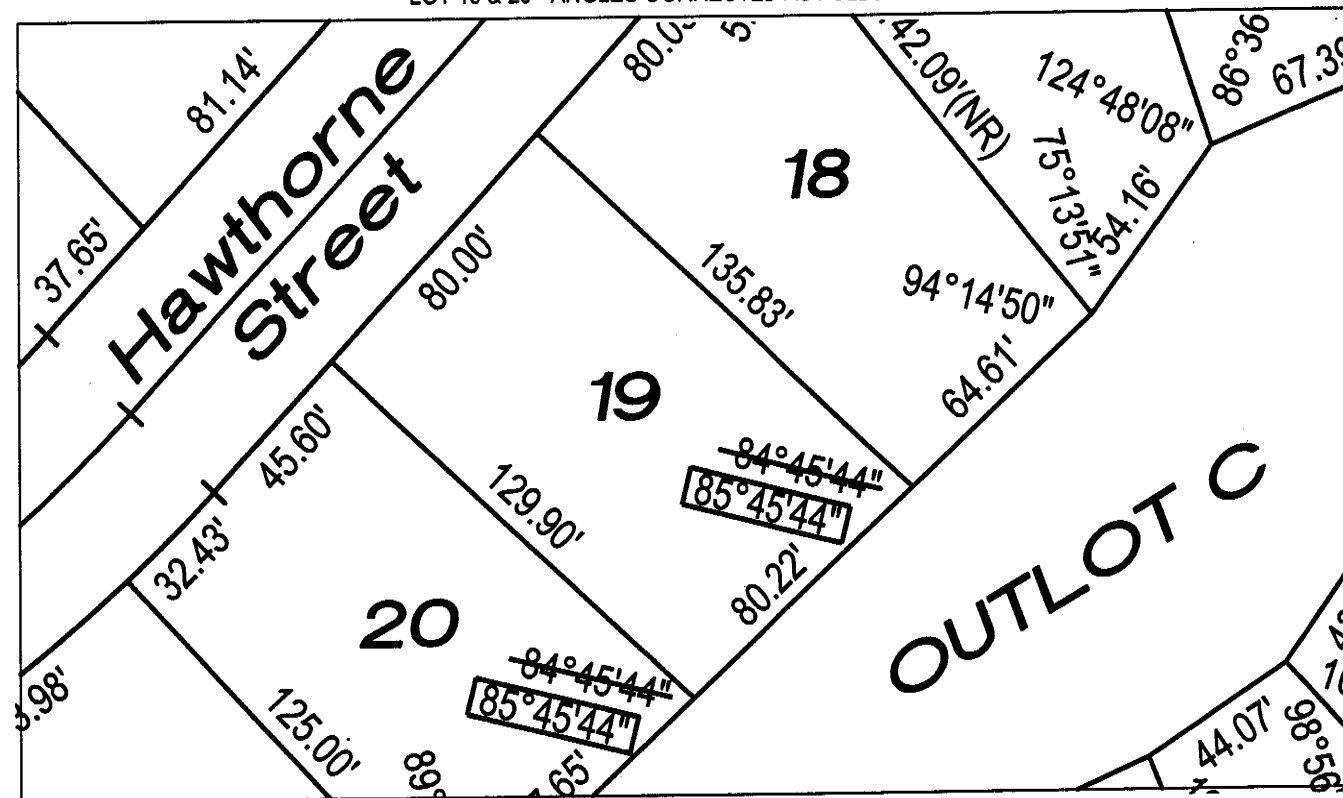


LOT 140 - DIMENSIONS CORRECTED AS FOLLOWS:

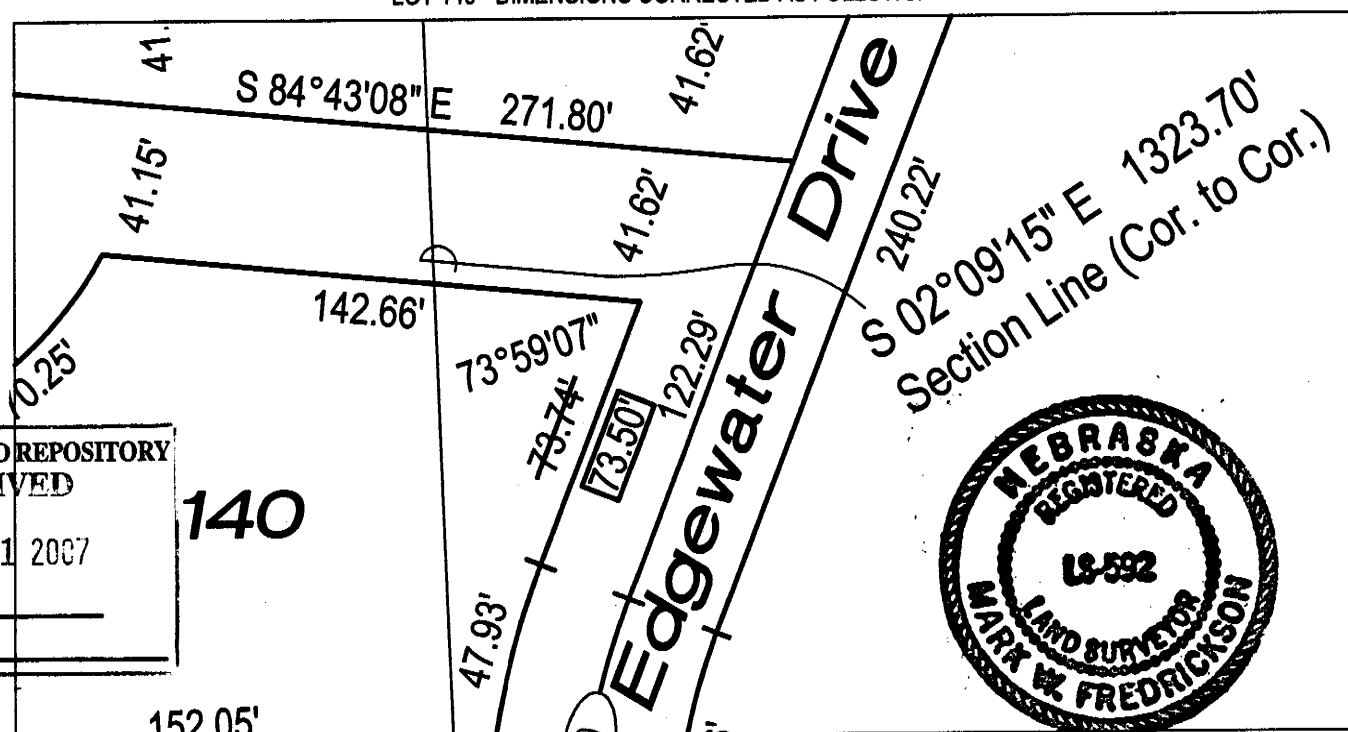

HAWTHORNE STREET - DIMENSIONS CORRECTED AS FOLLOWS:

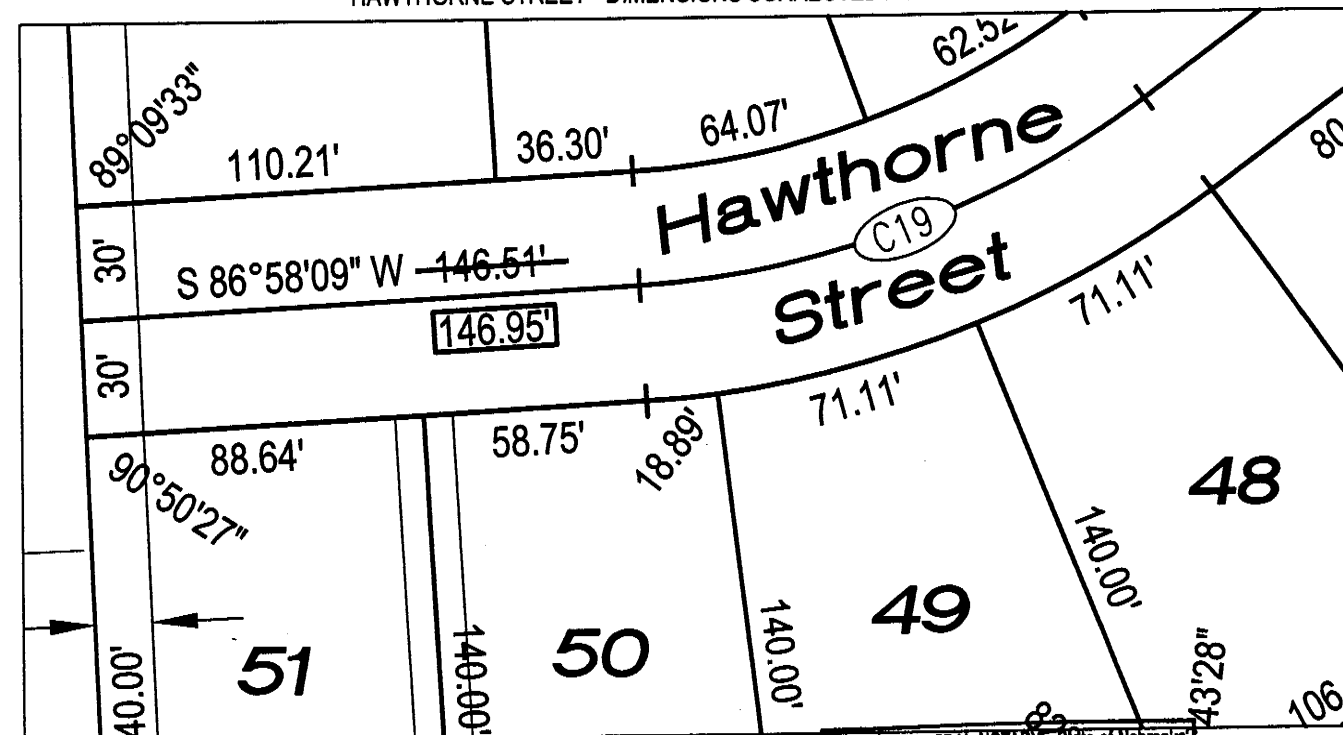

SURVEY RECORD REPOSITORY
RECEIVED
MAY 31 2007
County

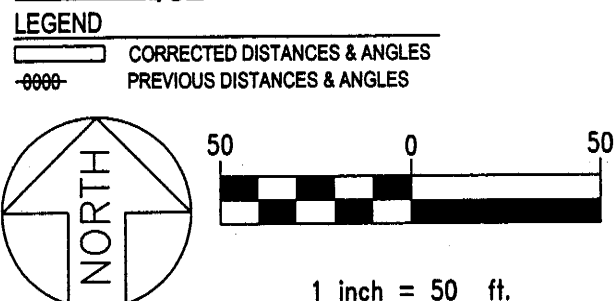

I, MARK W. FREDRICKSON, DO HEREBY SUBMIT THE ABOVE CORRECTIONS IN ORDER TO CORRECT ERRORS IN THE PLAT OF RIDGEWOOD SUBDIVISION AS DESCRIBED ABOVE.

I CERTIFY THAT I AM THE SAME IDENTICAL PERSON WHOSE NAME APPEARS IN THE SURVEYOR'S CERTIFICATE OF SAID RIDGEWOOD SUBDIVISION, DOUGLAS COUNTY, NEBRASKA.

Mark W. Fredrickson
MARK W. FREDRICKSON, R.L.S. #592

5-29-07
DATE

STATE OF NEBRASKA)

COUNTY OF DOUGLAS)
ON THIS 29 DAY OF May, 2007, BEFORE ME, THE UNDERSIGNED NOTARY PUBLIC, DULY QUALIFIED AND COMMISSIONED IN AND FOR SAID COUNTY AND STATE, PERSONALLY APPEARED MARK W. FREDRICKSON WHO IS PERSONALLY KNOWN BY ME TO BE THE IDENTICAL PERSONS WHOSE NAMES ARE AFFIXED TO THE OWNERS CERTIFICATION AND THEY DID ACKNOWLEDGE THE EXECUTION THEREOF TO BE THEIR VOLUNTARY ACT AND DEED.

Grace I. Stoddard
NOTARY

GENERAL NOTARY - State of Nebraska
GRACE I. STODDARD
My Comm. Exp. Aug. 9, 2008

MY COMMISSION EXPIRES ON: 08/09/2008

815-692 7/2

DESIGNED	DRAWN	CHECKED	DATE	BY	REVISIONS
<p>THE SURVEYOR'S NAME AND FIRM ARE TO BE PRINTED IN PLAIN INK ON THE SURVEY RECORD REPOSITORY RECEIVED. THE SURVEYOR'S NAME AND FIRM ARE TO BE PRINTED IN PLAIN INK ON THE SURVEY RECORD REPOSITORY RECEIVED. THE SURVEYOR'S NAME AND FIRM ARE TO BE PRINTED IN PLAIN INK ON THE SURVEY RECORD REPOSITORY RECEIVED.</p>					
<p>SCHEMMER Architects Engineers</p>					
<p>RIDGEWOOD PART OF THE SOUTHWEST 1/4 AND PART OF THE SOUTHEAST 1/4 SECTION 11, TOWNSHIP 16 NORTH, RANGE 11 EAST 6th P.M., DOUGLAS COUNTY, NEBRASKA</p>					
<p>AFFIDAVIT OF CORRECTION</p>					
<p>JOB NO. 04585.001</p>					
<p>SHEET 1-1</p>					
<p>1 OF 1</p>					